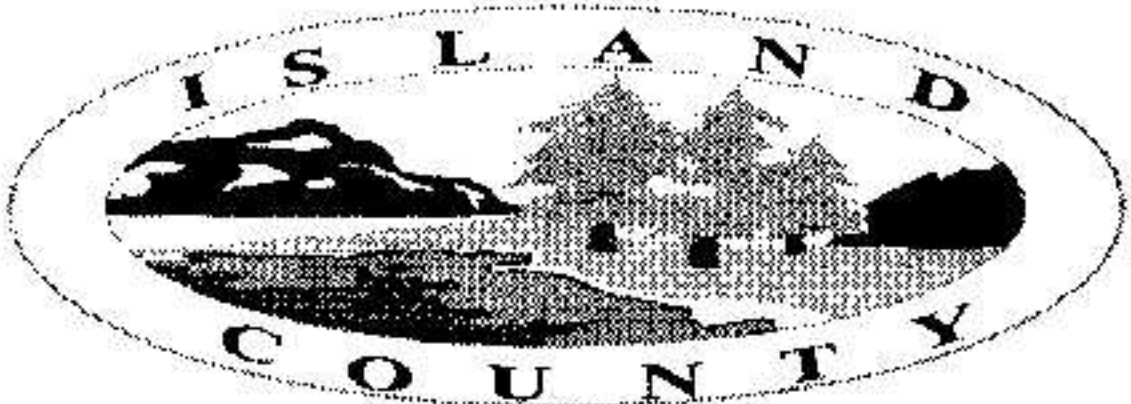


Receipt # 160090As Built # 799-06cIsland County Health Department
PO Box 5000 Coupeville WA 98239**ASBUILT****PERMIT TO CONSTRUCT A SEWAGE DISPOSAL SYSTEM**Applicant Name: DARRYL JONES Phone #: 360-239-4713

Owner Name: _____

Mailing Address: 4131 SE CAMANO CT. 98282Tax Parcel Number: R23114-242-342⁸⁰ Rge: _____ Sec: _____

Off-site Drainfield Parcel Number (if applicable): _____

Address of Construction Site: CIRCLE DRProperty Length: 319' Property Width: 135 Area: _____Name of Water System: CAMANO CITY WATER Private Well ☐Are there any critical areas within 100 feet of the property? ☒ No Yes ☐ (attach report)Are there any bluffs or banks within 100 feet of the project? ☒ No Yes ☐ (attach report)Is property in an archeologically significant area? ☒ No Yes ☐ (attach report)Is property within 800 feet of protected species area or on the shoreline? ☒ No Yes ☐ (attach report)Type of Use: Residential: ☐ Restaurant ☐ Other: _____ (attach narrative)Number of Bedrooms: 3 Projected Gallons per day: 450Soil Type: 4 Site Registration # 093-35Drainfield Size: 1126 sq feet Length: 57.2 ft Width: 22 ftTrench Depth: 6 in Septic Tank Size: EXISTING gal Pump Chamber Size: EXISTING gal

Designer Comments:

EXISTING HOME DRIP SYSTEM/ATU ADDED TO
REPLACE /LOCATE SAND FILTER AND DRAINFIELD FORHealth Department Comments: FUTURE BLA**RECEIVED**

SEP 17 2006

Island County Health Dept

We understand that changes to this site such as grading, filling or clearing, or any deviation from the original plan (as depicted on back) such as, but not limited to : (a) dwelling location, (b) placement of wells, drainfields, curtain drains, tanks, etc. without the Health Department approval from the Island County Health Department, may void this permit.

Owner Signature: [Signature] Date: _____Designer's / Agents Signature: [Signature] Date: 9/6/06

This permit is issued with the understanding that the property owner will allow, in perpetuity, a Health Department representative to enter onto this property during reasonable hours, for the sole purpose of monitoring the performance of the sewage disposal system.

A permit to construct a sewage disposal system shall be valid for three years from the date of issuance. Permits are transferable with property ownership provided the new owners accept the permitted plan. If the system is not installed within three years, a new permit may be applied for based on current standards and requirements.

For Health Department Use OnlySystem Type: Conventional ☐ Alternative ☒ Commercial / Community ☐Water Approved? No ☐ Yes ☐ By: EXISTING Restrictive Covenant: No ☐ Yes ☐ AF# _____Drainfield Easement: No ☐ Yes ☐ AF# _____ O&M Required: No ☐ Yes ☒ AF# 490003Plan Approved [Signature] Plan Disapproved _____ Date: 10/23/06Permit Number: 799-06c Expiration Date: 10/23/09System Installed by: Olsen Construction inspection date(s): 11/20/06

Final Inspection: Approved: _____ Rejected: _____ Date: _____

As-Built Approval: Approved: [Signature] Rejected: _____ Date: 1/17/07**ASBUILT**

799-06c



Property Owner: Darryl Jones As-Built #: 799-060

Island County Health Department

PO Box 5000 Coupeville WA 98239

Parcel # R 23114-242-3480

Septic System As-Built


ASBUILT

Provide Accurate Plot Plan to Scale Including but not Limited to:

Drainfields, wells, tanks, banks, buildings, roads, utilities, easements, property lines, critical areas, etc.

Scale 1 inch = 30 ft

North Arrow

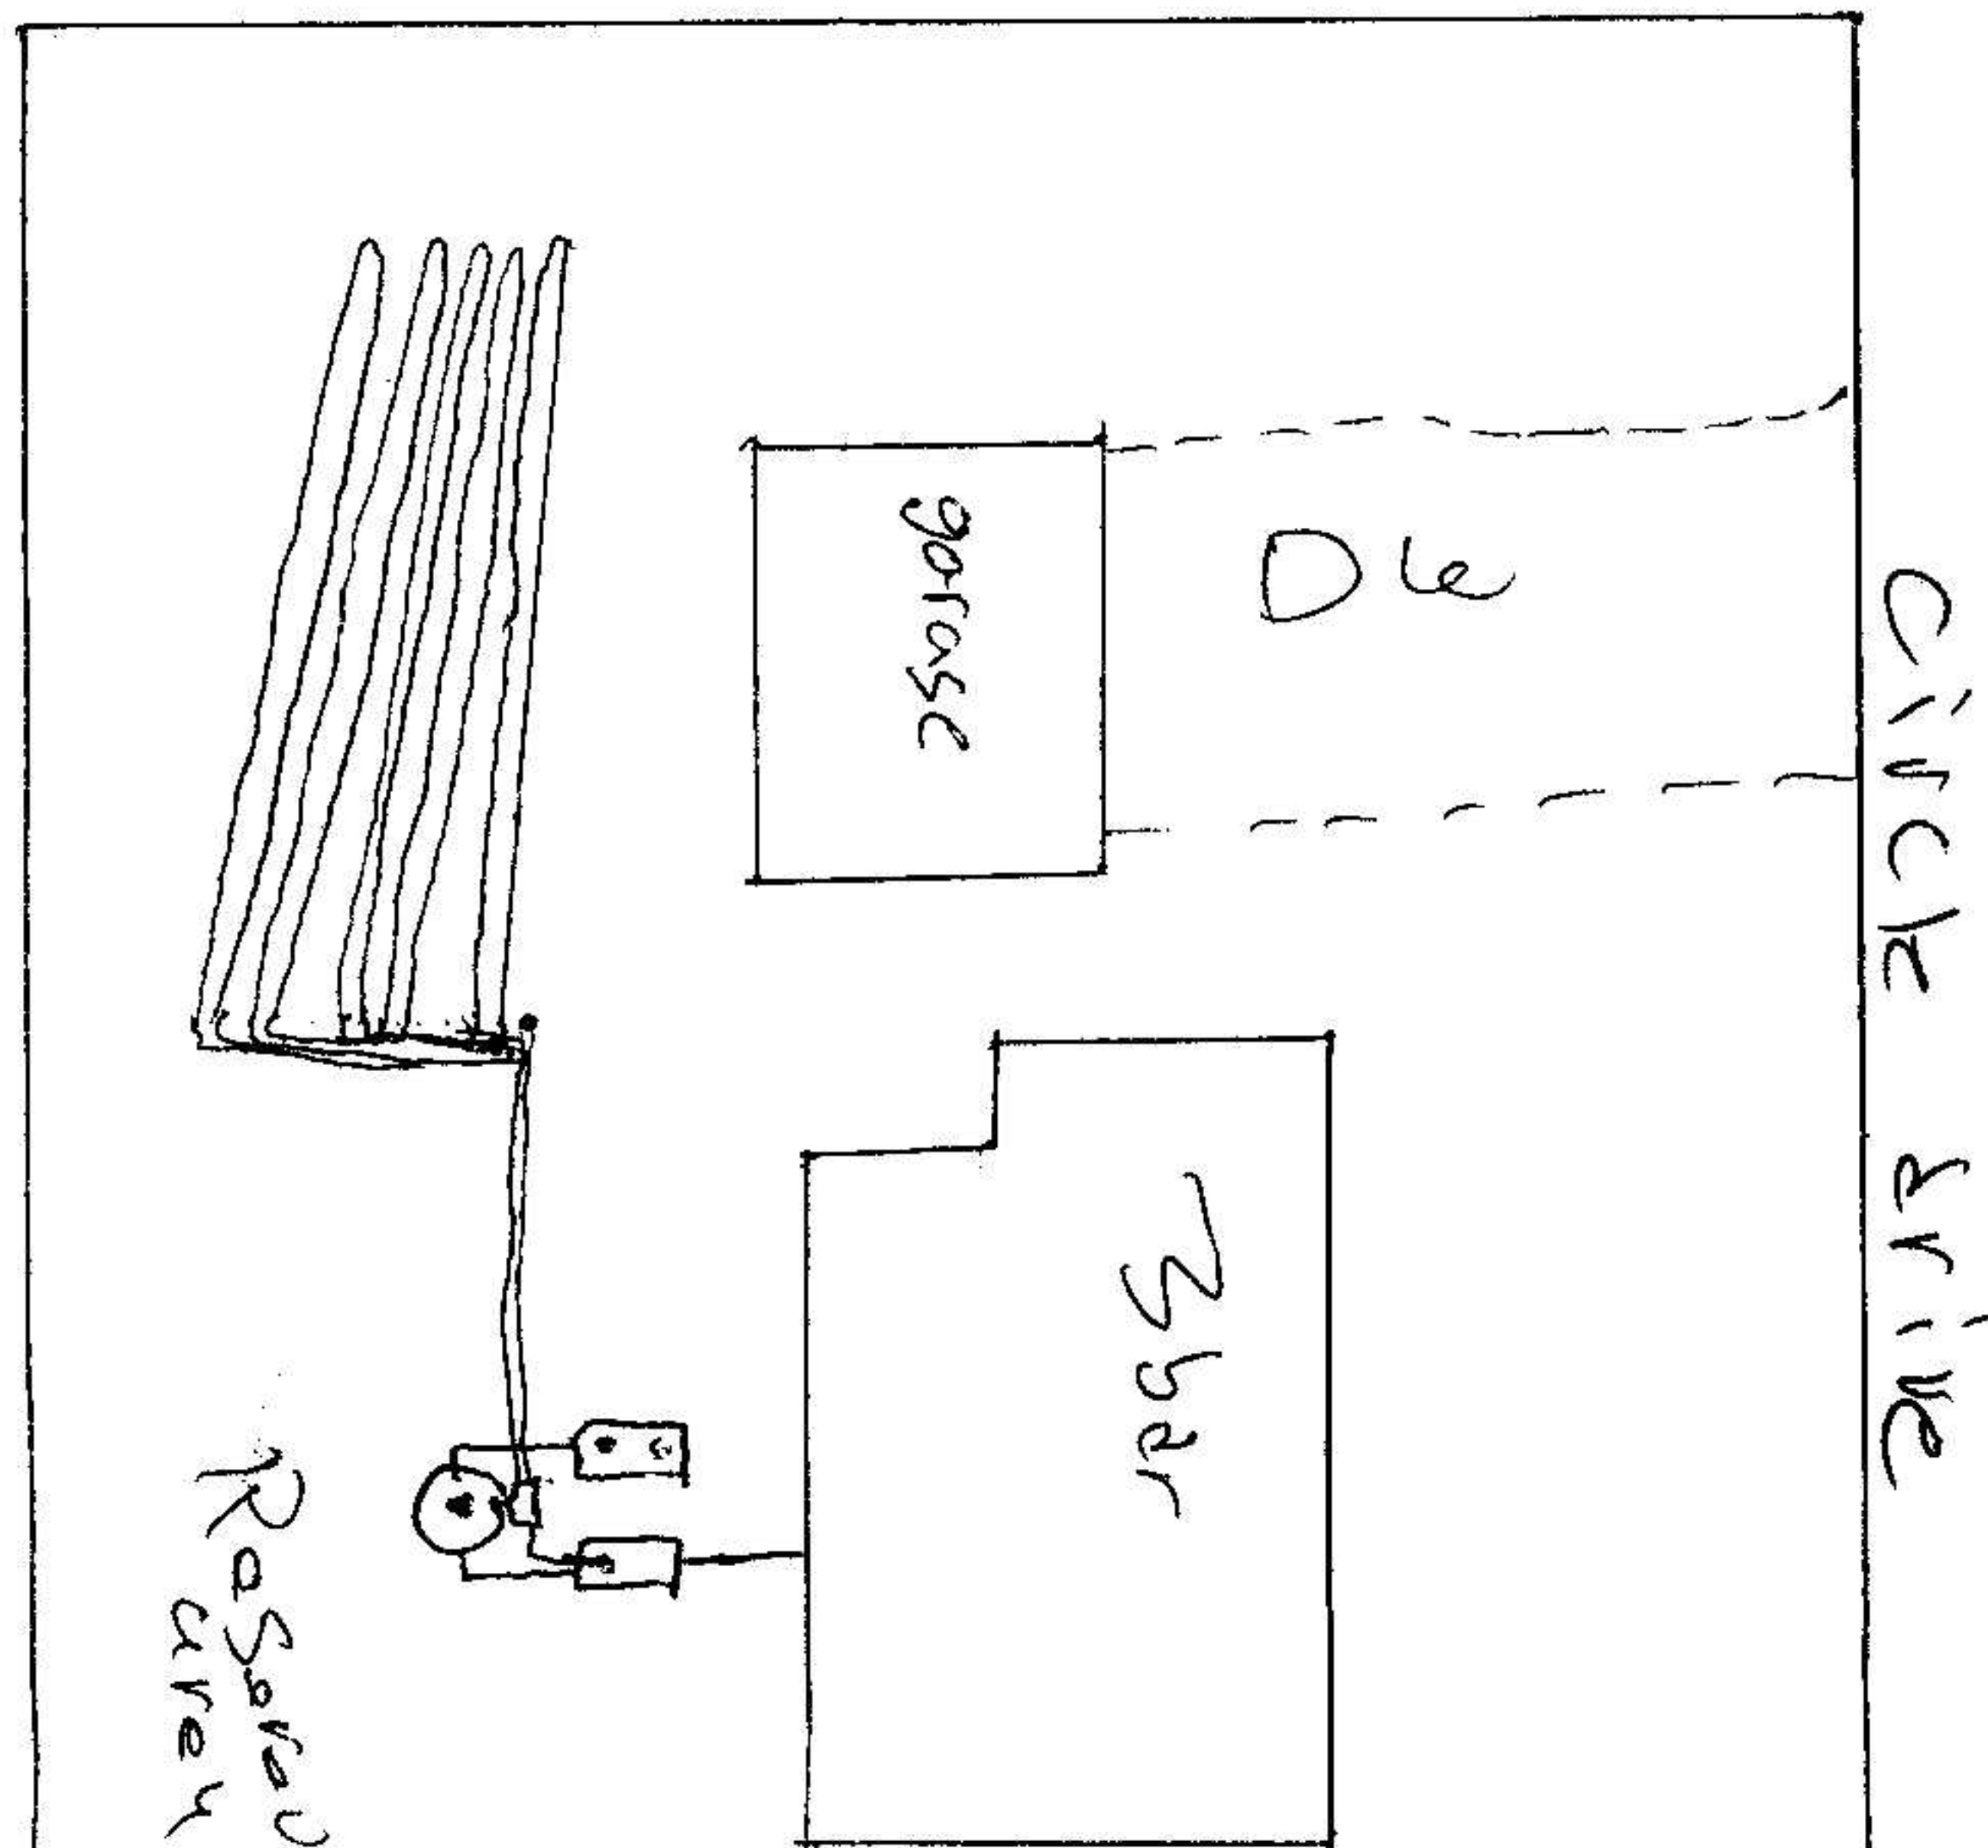

RECEIVED

JAN 12 2007

Island County Health Dept
Camano

Comments:

I, the undersigned, personally inspected this On-site Sewage Disposal system and certify that it was installed in accordance with the approved design, including all requirements deemed necessary by all proprietary devices and this system fully complies with all conditions of I.C.C 8.07.

Installers Signature: [Signature]

Date Installed: 11-14-06

ASBUILT

Lead Pump

Time Dosed: ☒ yes ☐ no

Pump Model: 5 timer

HP: 1/2

Run Time: 5 min

Off Time: 2 hr

Volume: 450 day gal

Secondary Pump

Time Dosed: ☐ yes ☐ no

Pump Model: _____

HP: _____

Run Time: _____

Off Time: _____

Volume: _____ gal

Pressure, Drip and Mound Info

Lateral length(s):

#1 114 #2 114 #3 114

#4 114 #5 114 #6 _____

Orifice Size: 3/16 in

Head/Pressure: _____ in / lbs.

of Orifices/Emitters: 570

Sand Filter Information

Square Feet: _____

Residual Head: _____ in

Orifice Size: _____ in

Number of Orifices: _____

Aerobic Treatment Info

Brand: Whitewater

Model: DF50

Disinfection: ☒ UV ☐ Other

Glendon Info

Basal Area: _____ sq ft

Final Dimension: _____

Tank Information

Manufacturer: Bore

Septic Tank Size: 100 gal

Pump Tank Size: 100 gal

Drainfield Info

Square Feet: 1144

Length: 52 ft

Width: 22 ft

Depth: 6 in